

PUBLIC REALM PROJECTS (PARKING DESIGN)



Environment and Leisure, Public Realm
PO Box 64529, London SE1 5LX

LEGEND

- Proposed double yellow line
- Single yellow line
- Double yellow line
- Single red line (TLRN)
- Double red lines (TLRN)
- Permit bay
- Disabled bay

Revision details	By	Date	Suffix
			A
			B

Project ID / name

1213Q3_LOCAL_PARKING_AMENDMENTS

Drawing title

CONGREVE STREET
PROPOSED_AAT_WAITING_RESTRICTIONS

Layout

APPENDIX_3

Scale


1:500_AT_A3

File Name

M1_AB_v4.dwg

Drawn	Designed	Checked	Approved
MH	MH	TW	TW
14/11/12	14/11/12	21/11/12	21/11/12

This map is based on Ordnance Survey material with the permission of Ordnance Survey on behalf of the Controller of Her Majesty's Stationary Office © Crown copyright. Unauthorised reproduction infringes Crown copyright and may lead to prosecution or civil proceedings. ((0)100019252) 2012

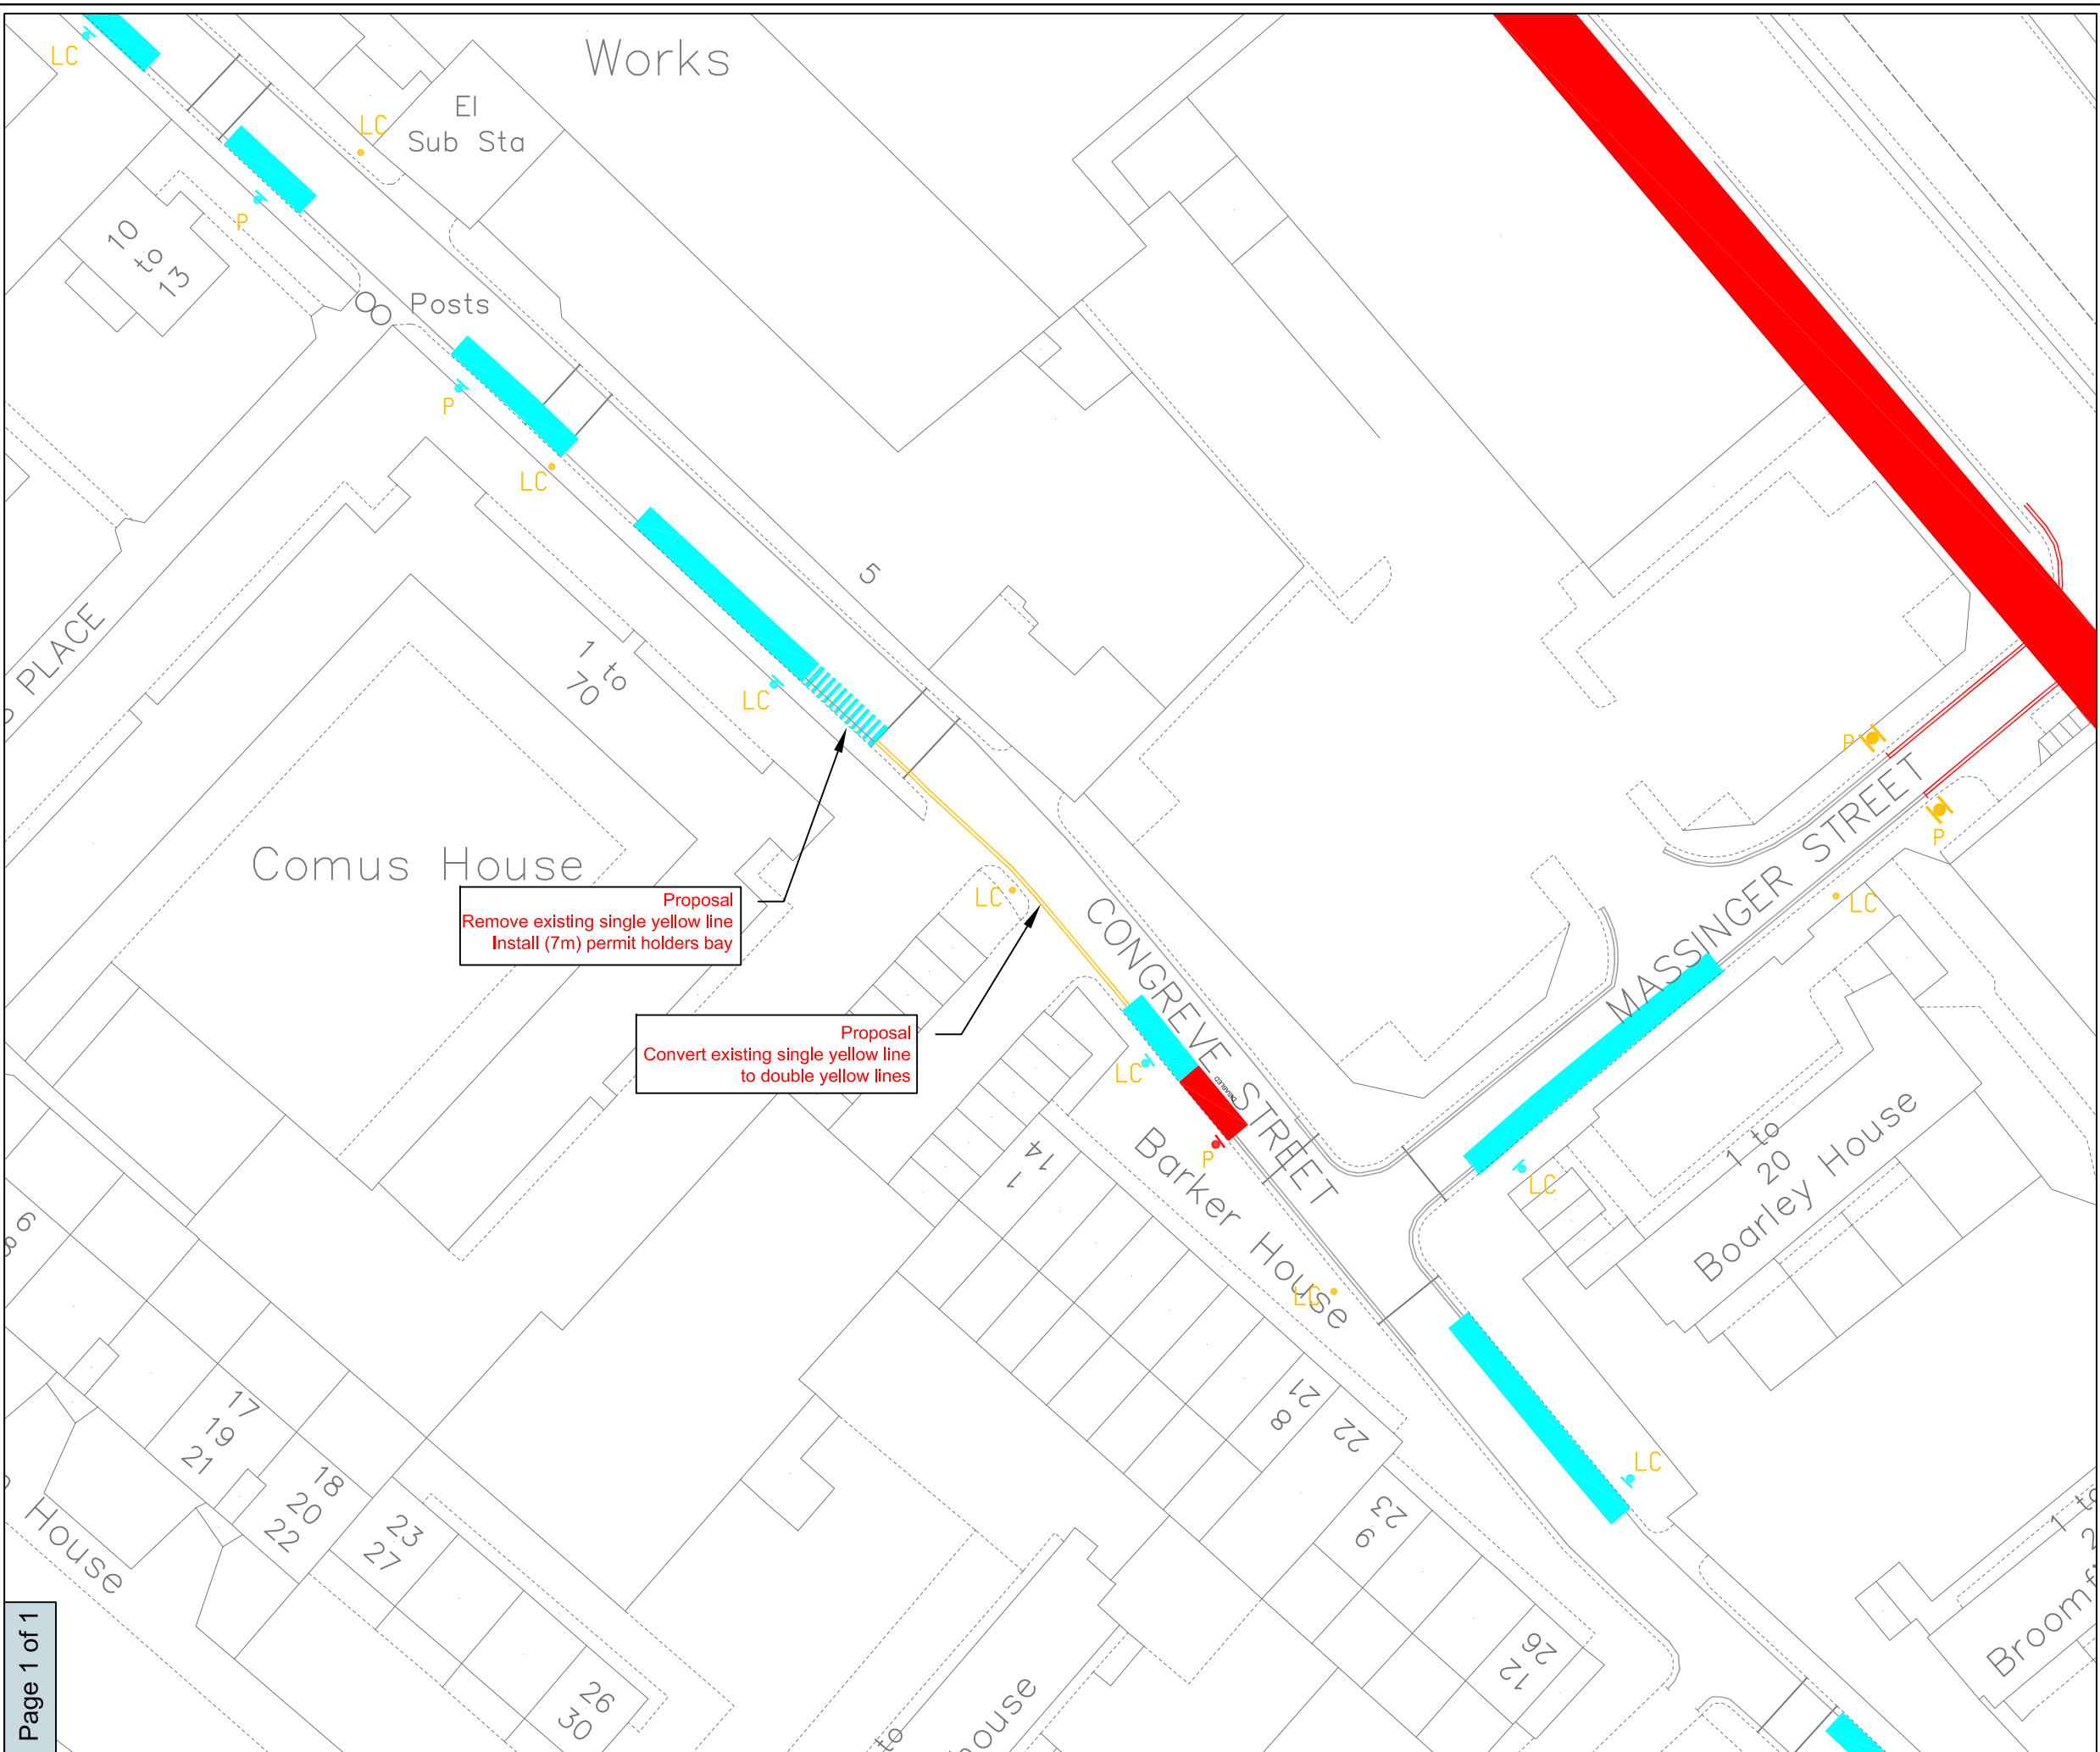

Proposal
Remove existing single yellow line
Install (7m) permit holders bay

Proposal
Convert existing single yellow line
to double yellow lines