


PUBLIC REALM PROJECTS (PARKING DESIGN)

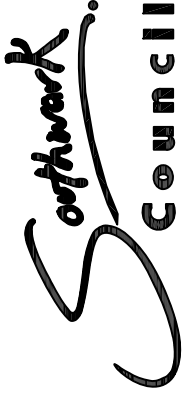

Environment and Leisure, Public Realm  
PO Box 64529, London SE1 5LX


LEGEND

- TLRN single red line
- TLRN single red line
- At any time waiting restriction
- Waiting restriction Mon-Sun 7am-7pm
- Waiting restriction Mon-Sat 830am-630pm
- Waiting restriction zone hours
- Permit holders only bay
- Loading only bay
- Disabled persons parking bay
- 4hr pay and display bay
- 4hr Shared use bay
- Solo motorcycles only bay
- 30min time restricted free bay
- Tree

Revision details	By	Date	Suffix
			A
			B

Project ID / name			
1213Q4_LOCAL_PARKING_AMENDMENTS			
Drawing title			
GROVE_LANE			
PROPOSED_AAT_WAITING_RESTRICTIONS			
Layout			
DETAILED_DESIGN			
Scale			
1:500_AT_A3			
File Name			
L_AB_V3.dwg			
Drawn	Designed	Checked	Approved
MH	MH	TW	TW
11/03/13	11/03/13	11/03/13	11/03/13

This map is based on Ordnance Survey material with the permission of Ordnance Survey on behalf of the Controller of Her Majesty's Stationary Office © Crown copyright. Unauthorised reproduction infringes Crown copyright and may lead to prosecution or civil proceedings. (0)100019252 2013

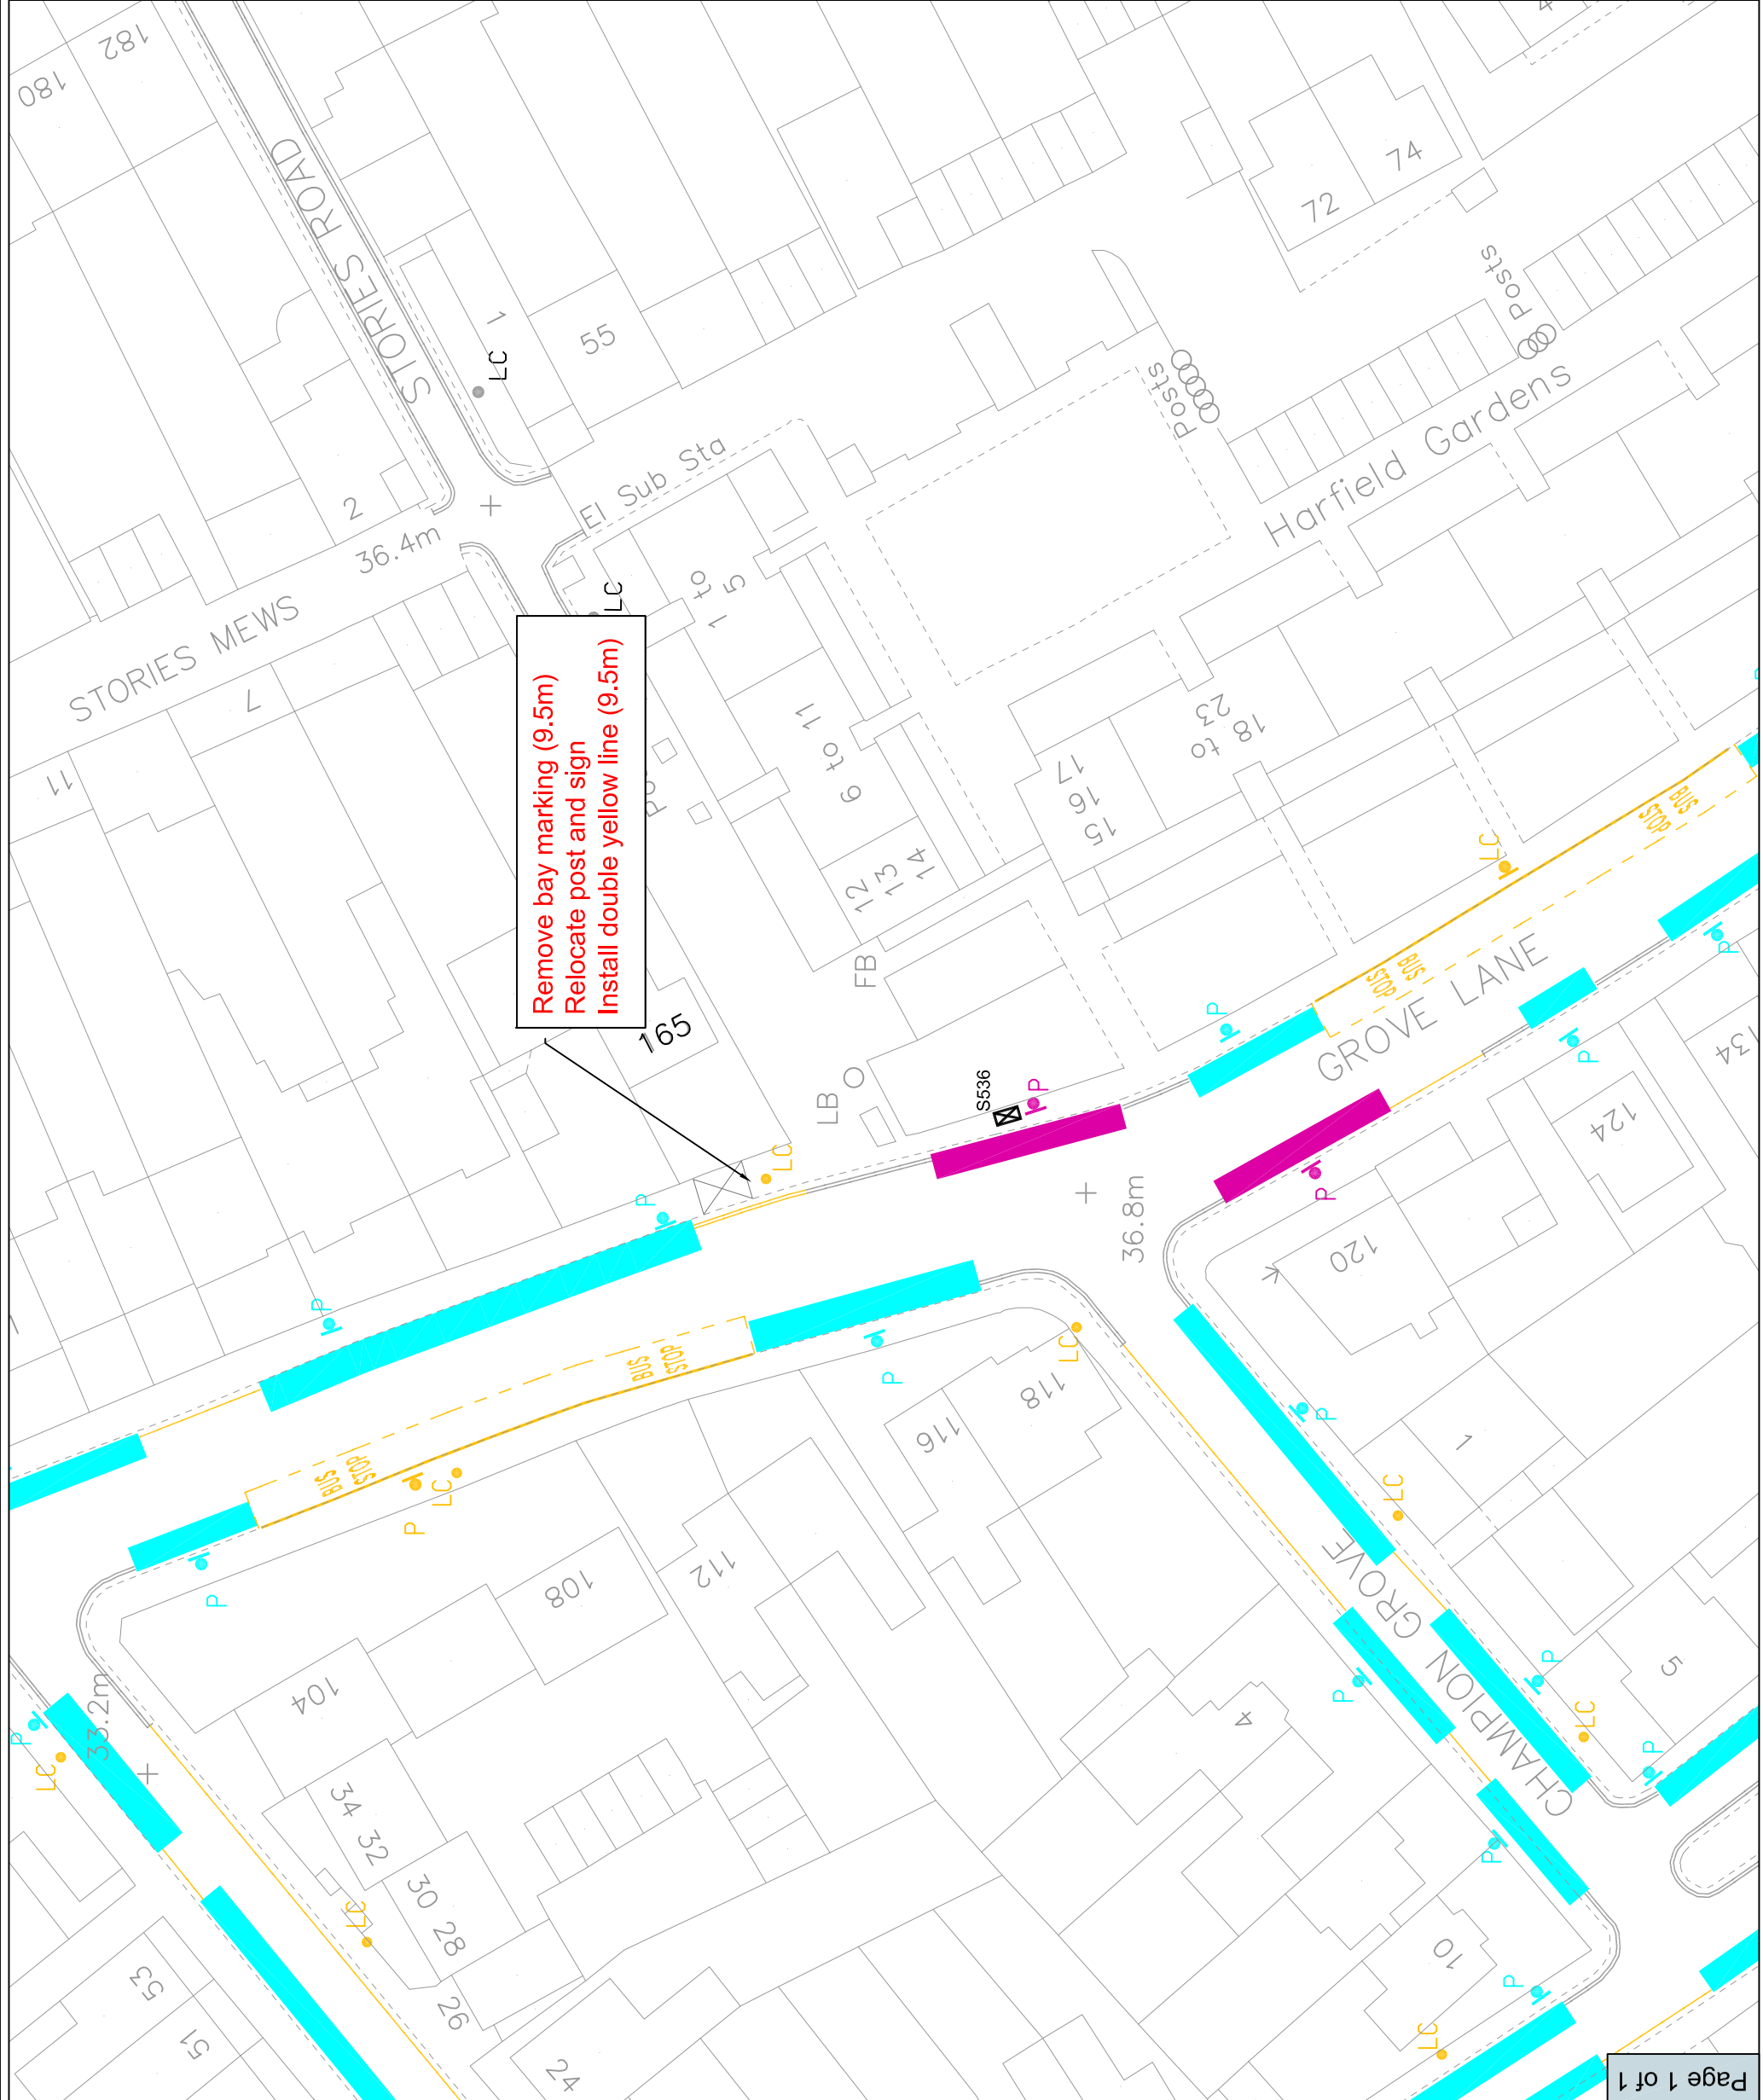

Remove bay marking (9.5m)  
Relocate post and sign  
Install double yellow line (9.5m)