


0mm 50mm
A3 ORIGINAL SHEET SIZE

General Notes:
1. All dimensions are given in millimetres, levels are given in metres;
2. All dimensions and conditions shall be verified on site before commencing any work or making any shop drawing;
3. This drawing shall be read in conjunction with all other relevant drawings, specifications and documentations issued in connection to this drawing;
4. Any discrepancies between the drawing and site conditions must be brought to the attention of the architect for resolution prior to conducting any construction work in that location or the placement of orders for items relating to that location;
5. All work shall comply with the current Building Regulations, requirements of the Local Authority and any current Codes of Practice and British Standards.

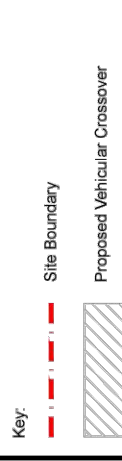

Rev	By	Description	Date
B	RW	Boundary line amended, timber fence to the rear added, bicycle store door amended	09 Dec 15
A	RW	Design amended to feedback from neighbours	20 Aug 15

Client

M Nawaz

Project Title

3a Friern Road
London SE22 0AU

Drawing Title

Proposed Vehicular Crossover


Copyright reserved to Brewer Smith and Brewer. This drawing is the property of Brewer Smith and Brewer Chartered Architects and is not to be reproduced nor used in any manner without prior consent from Brewer Smith and Brewer.

Brewer Smith & Brewer
Chartered architects
London, Birmingham, Bridgwater, Abu Dhabi, Dubai
London SW20 0AU | Tel: 020 8949 2321 | Fax: 020 8949 2320

Date: 20 May 15
Scale: 1:200@A3
Drawing Number: 4547/17B

BSB

4547/17B

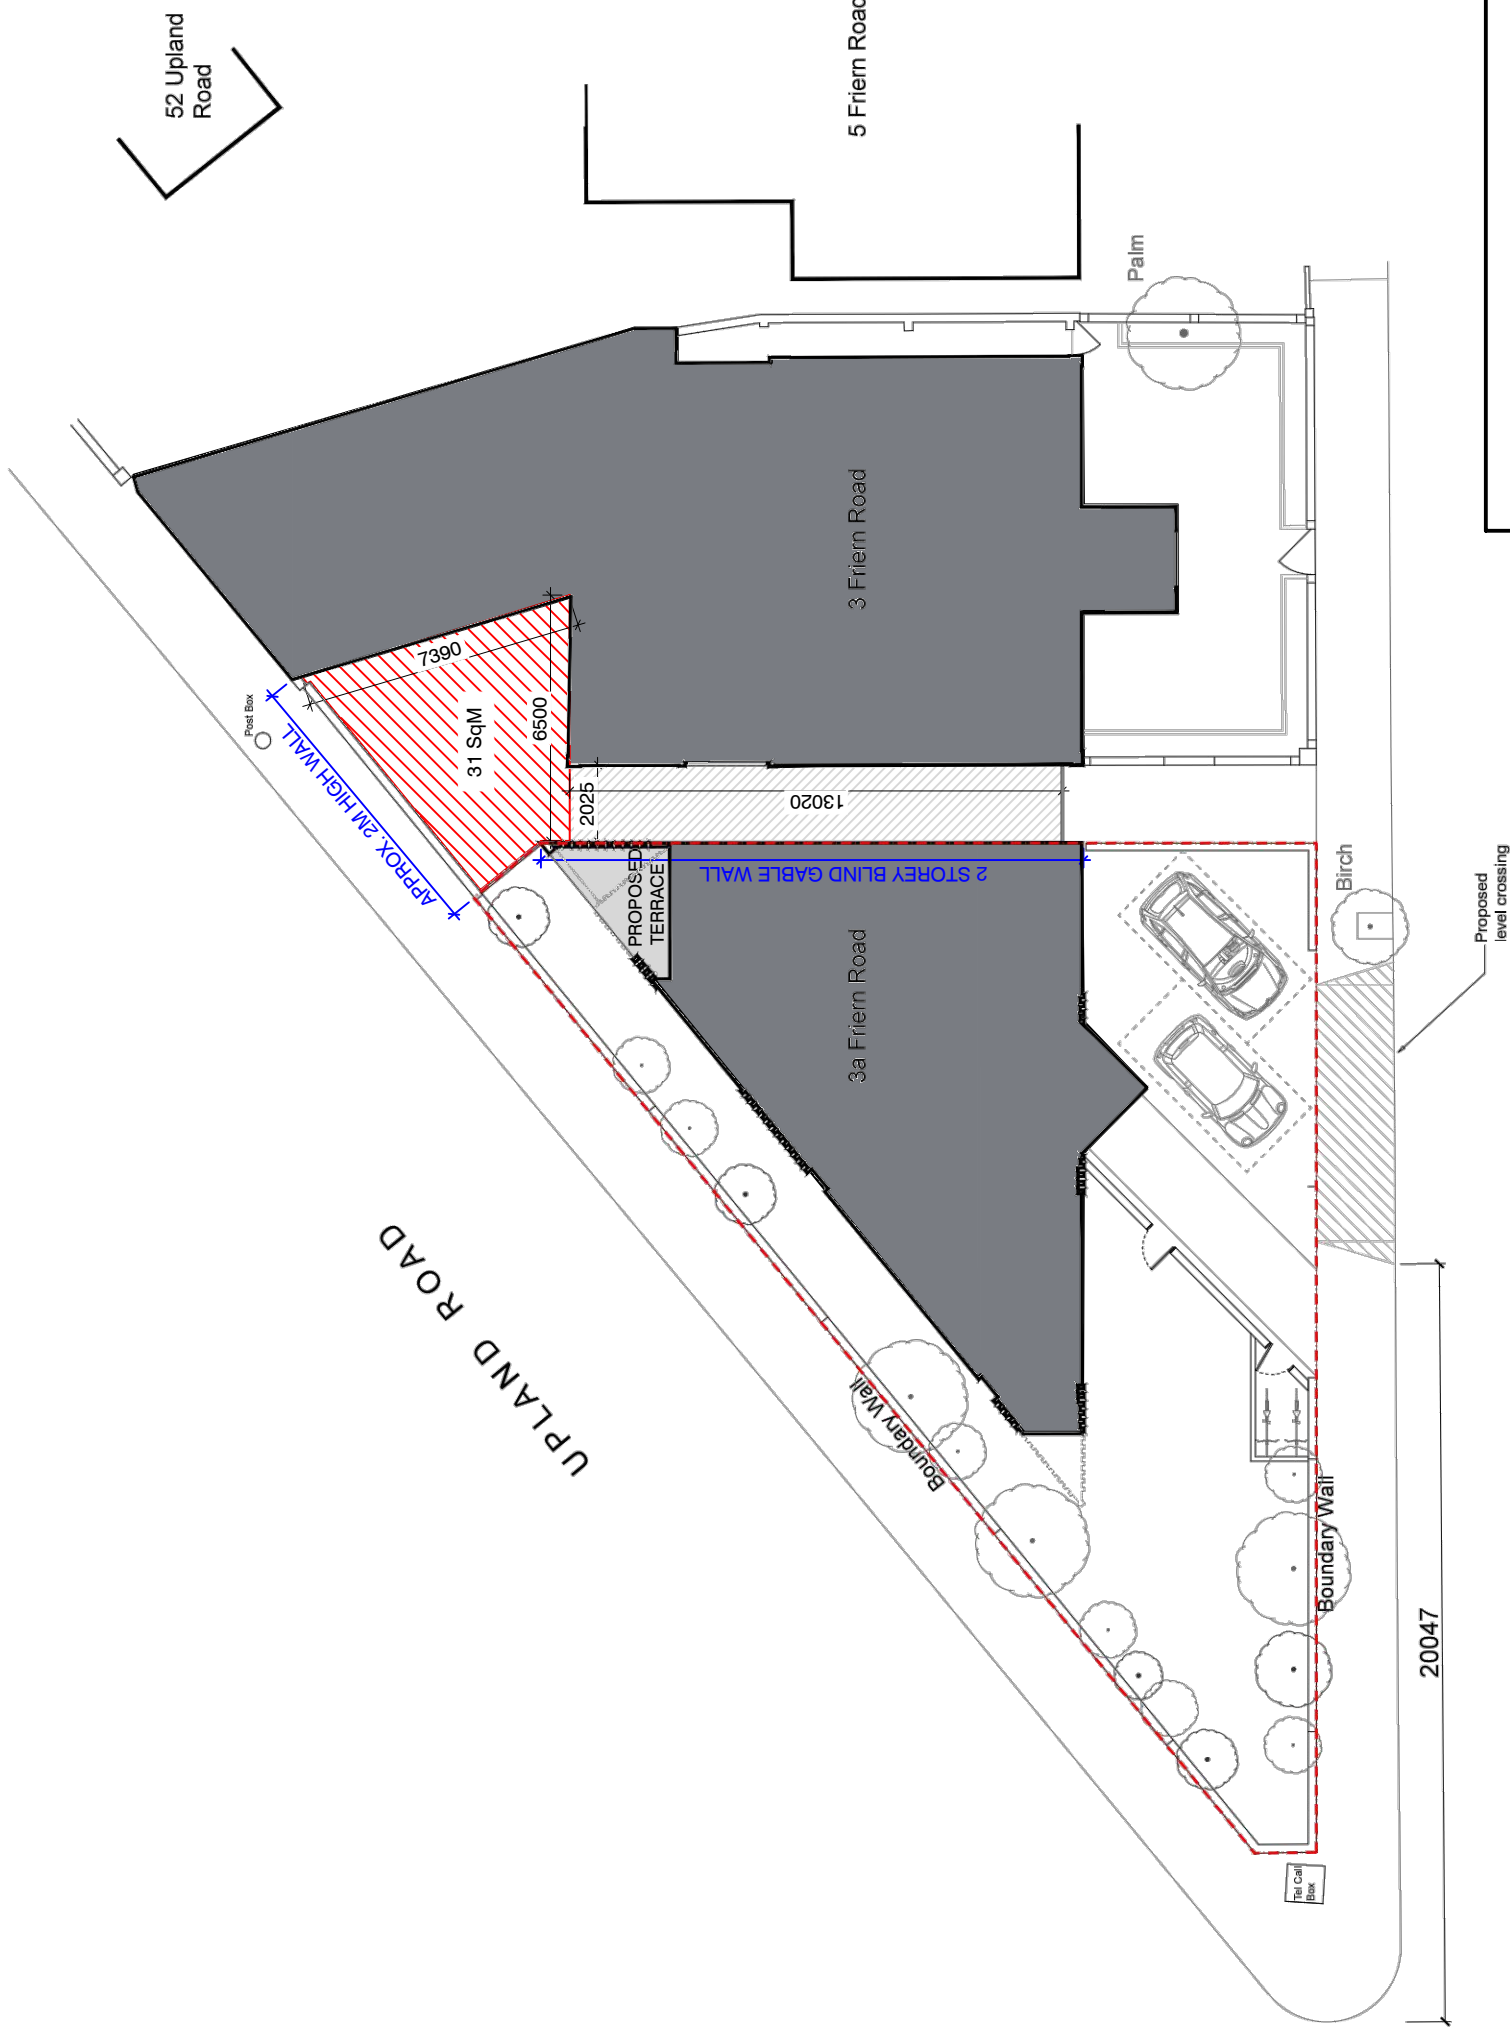

ANNOTATION ADDED TO IDENTIFY AMENITY SPACE PROVISION PROVIDED AT REAR OF PROPERTY, WHERE PRIVACY IS AVAILABLE.
REF: 4547-17B Mark Up

FRIERN ROAD