








PROPOSAL - REMOVE 39.75m OF SINGLE YELLOW LINES AND REPLACE WITH PERMIT HOLDER ONLY PARKING BAY

NOTES

-  Existing yellow lines
-  Existing Red Lines
-  Existing PH parking bay
-  Proposed PH parking bay

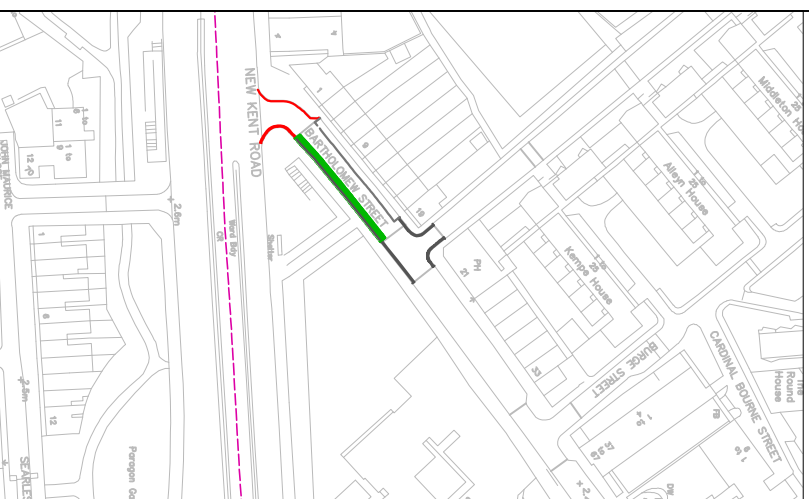

REV	DATE	REVISION DESCRIPTION / DETAILS	DRN	CHKD	APPROV



169 TOOLEY STREET LONDON SE1P 6LX

18/19 Q4B MTS
BARTHLOMEW STREET

MASTERPLAN

STATUS	DESIGNED	CHECKED	APPROVED

SCALE	1:200

DRAWING NO	LBS/BS1

DATE DRAWN	06 FEBRUARY 2019	DATE ISSUED	06 FEBRUARY 2019