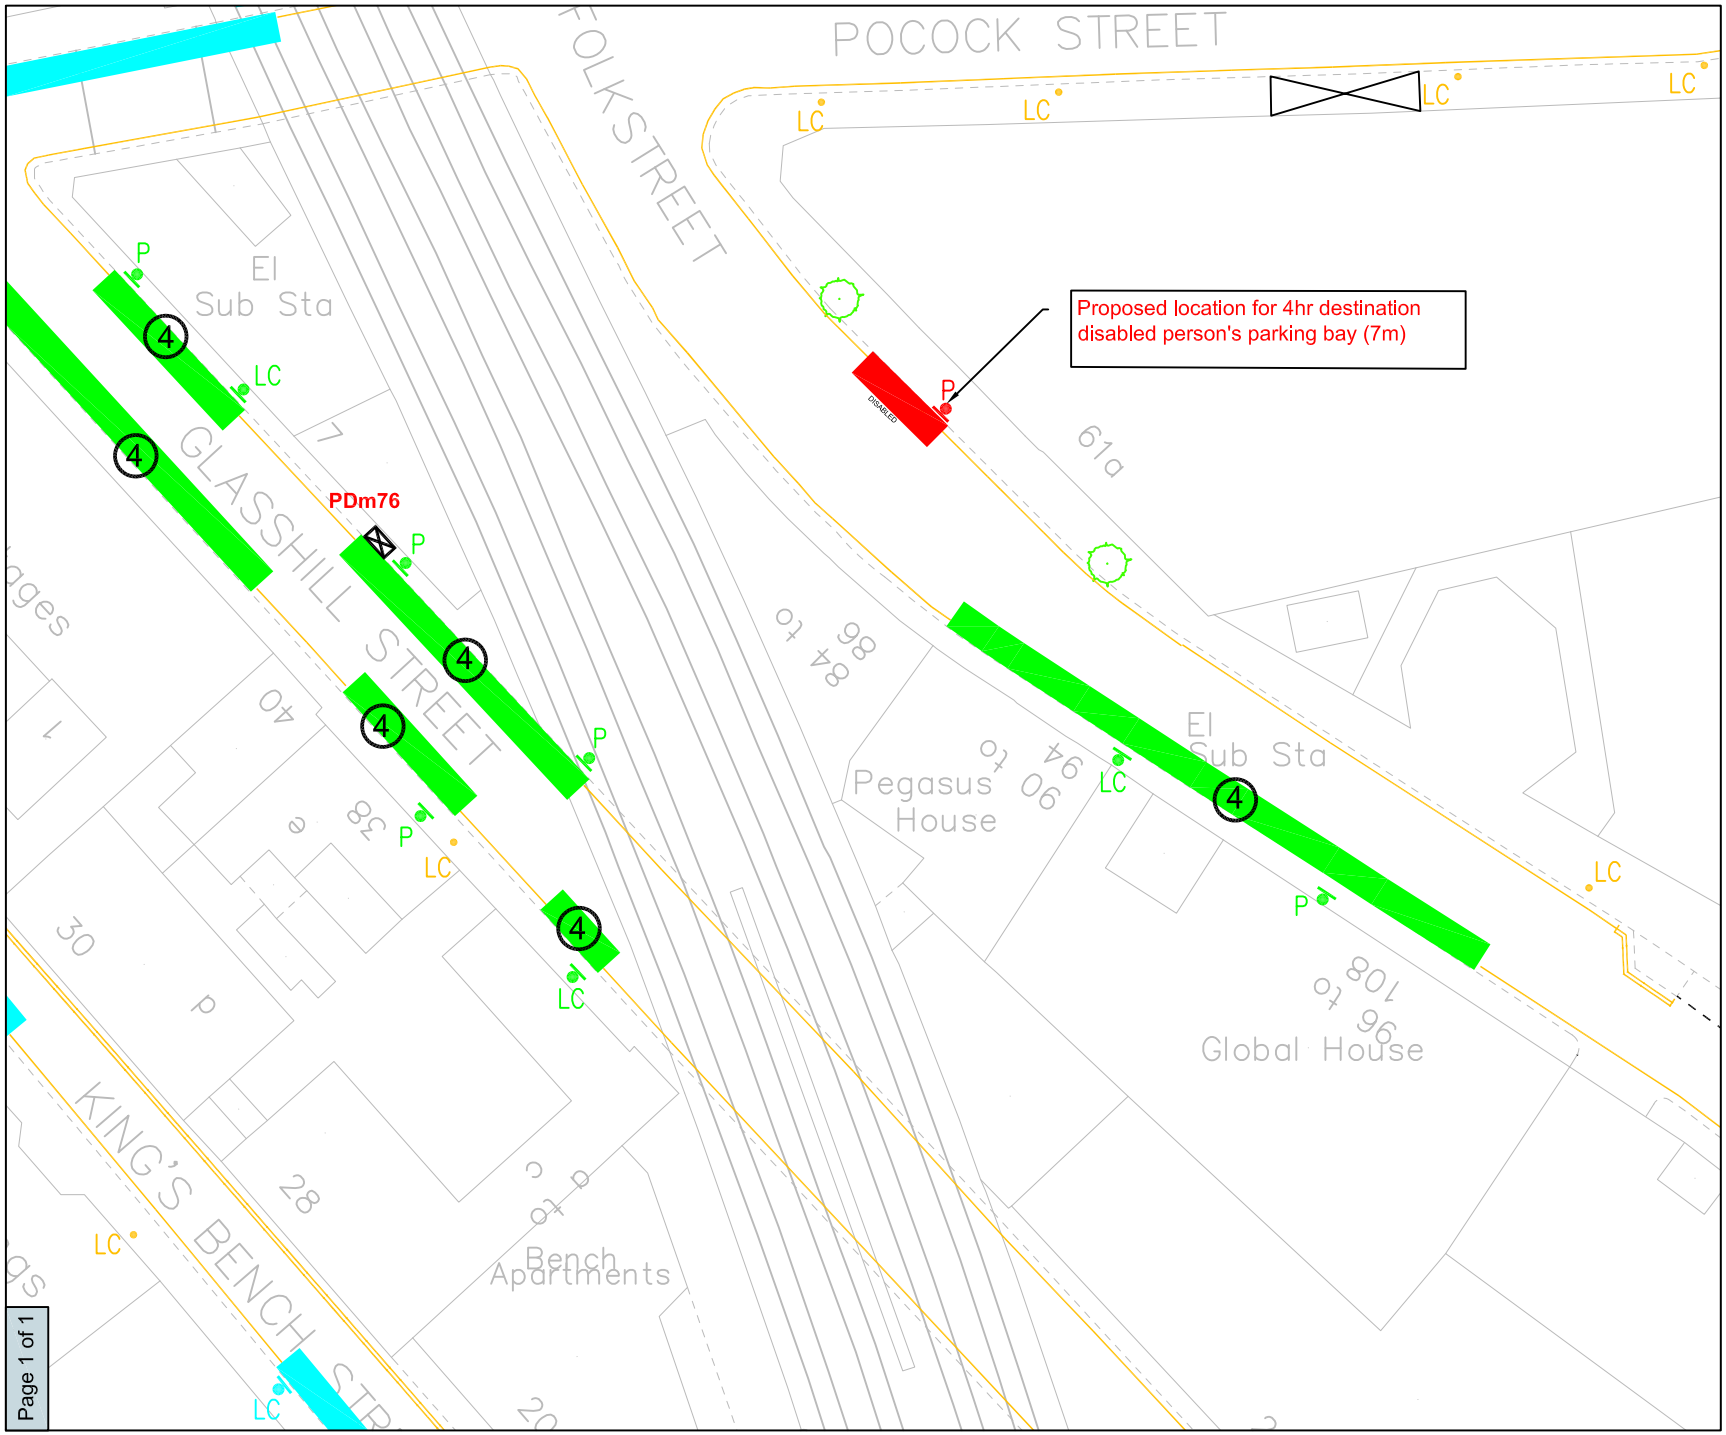

PUBLIC REALM PROJECTS (PARKING DESIGN)

Southwark Council

Environment and Leisure, Public Realm
PO Box 64529, London SE1 5LX

LEGEND

- EXISTING DOUBLE YELLOW LINES
- EXISTING SINGLE YELLOW LINE
- EXISTING SINGLE KERB STRIPE
- EXISTING PERMIT BAY
- EXISTING PAY AND DISPLAY BAY
- EXISTING SOLO MOTORCYCLE BAY
- EXISTING LOADING ONLY BAY
- EXISTING DISABLED BAY
- EXISTING SINGLE KERB STRIPE
- EXISTING BUS BAY
- EXISTING CYCLE HIRE DOCKING STATION
- EXISTING AMBULANCE BAY
- EXISTING SHARED USE BAY
- EXISTING SINGLE METER
- PROPOSED DISABLED BAY

Revision details	By	Date	Suffix
			A
			B

Project ID / name

1314Q2_LOCAL_PARKING_AMENDMENTS

Drawing title

GREAT_SUFFOLK_STREET
PROPOSED_DISABLED_PARKING_BAY

Layout

APPENDIX_3

Scale

1:500_AT_A4

File name

1314Q2_016

Drawn	Designed	Checked	Approved
MH 29/07/13	MH 29/07/13	TW 12/08/13	TW 12/08/13

© Crown copyright. All rights reserved ((0)100019252) 2013

APPENDIX 3

S:\NET_DEV\01_PROJECTS\2006_07\C2_CPZ_4TH_2006\11 Design Drawings\04 As Built\C2_AB_V5.dwg