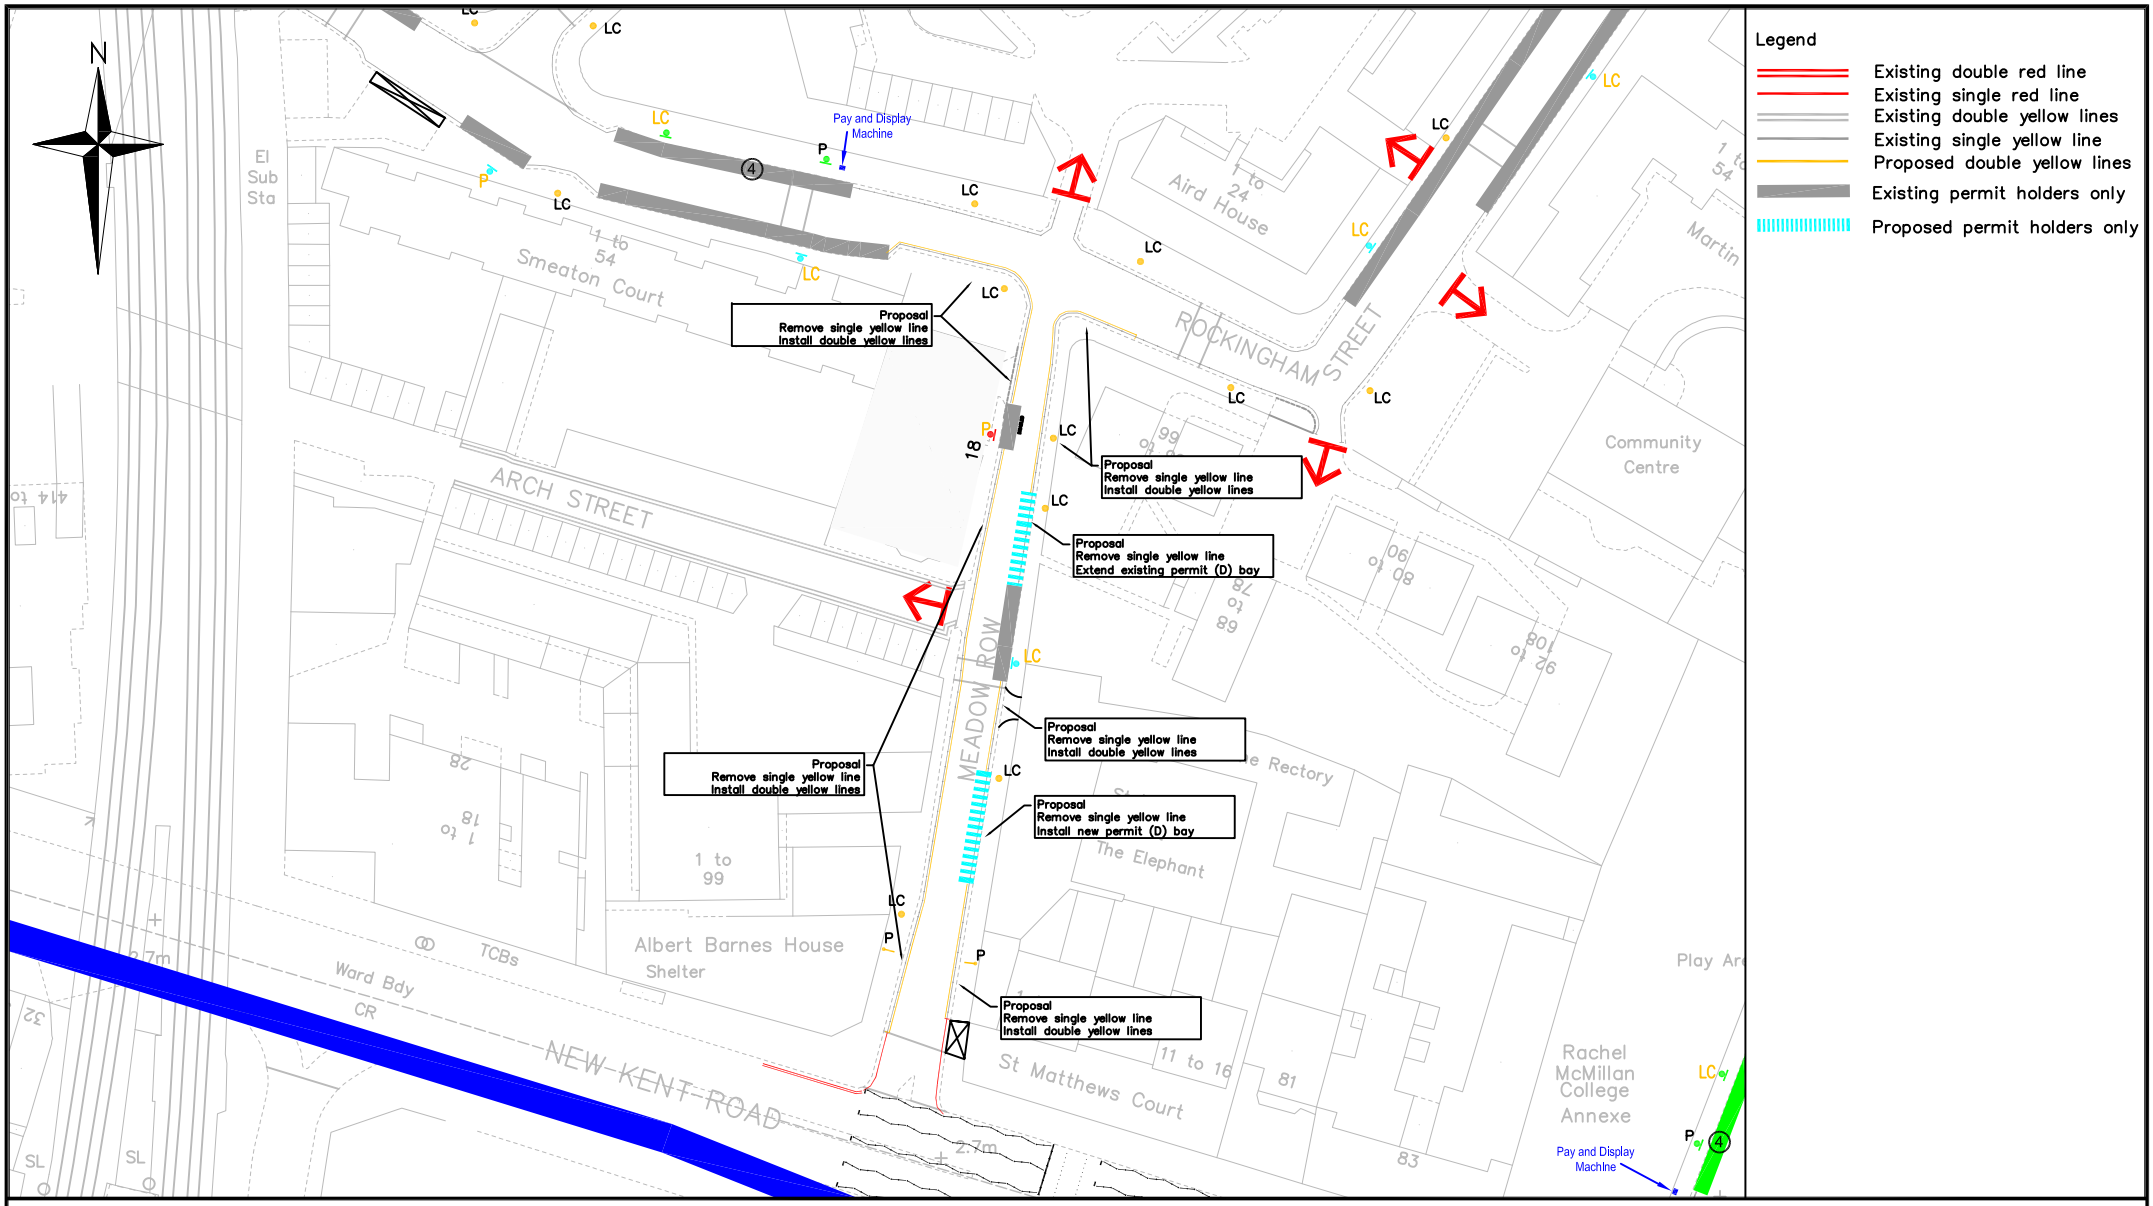

Public Realm Projects
Parking Design

Environment and Leisure
Floor 3, hub 1
Southwark Council
160 Tooley Street
PO Box 64529
London, SE1P 5LX

www.southwark.gov.uk/parkingprojects

Southwark Council

Project	1415Q3 LOCAL PARKING AMENDMENTS
Community Council	BOROUGH, BANKSIDE AND WALWORTH
Ward(s)	CHAUCER
Drawing Title	MEADOW ROW PROPOSED DOUBLE YELLOW LINES PROPOSED EXTENSION PERMIT (D) BAYS

Date	Scale	Drn	Chk	App
05/11/14	1:1000 @ A4	MH	TW	TW

Dwg No.	1415Q3_004	Rev
Status	APPENDIX 1	A

Rev	Date	Description	Drn	Chk	App

© Crown copyright and database rights 2014 Ordnance Survey (0)100019252

APPENDIX 1

\\lbsish-cha-ns1\151share\NET_DEV\01_PROJECTS\2006_07\D_CPZ_4TH_2006\11 Design Drawings\04 As Built\D_AB_V2.dwg.