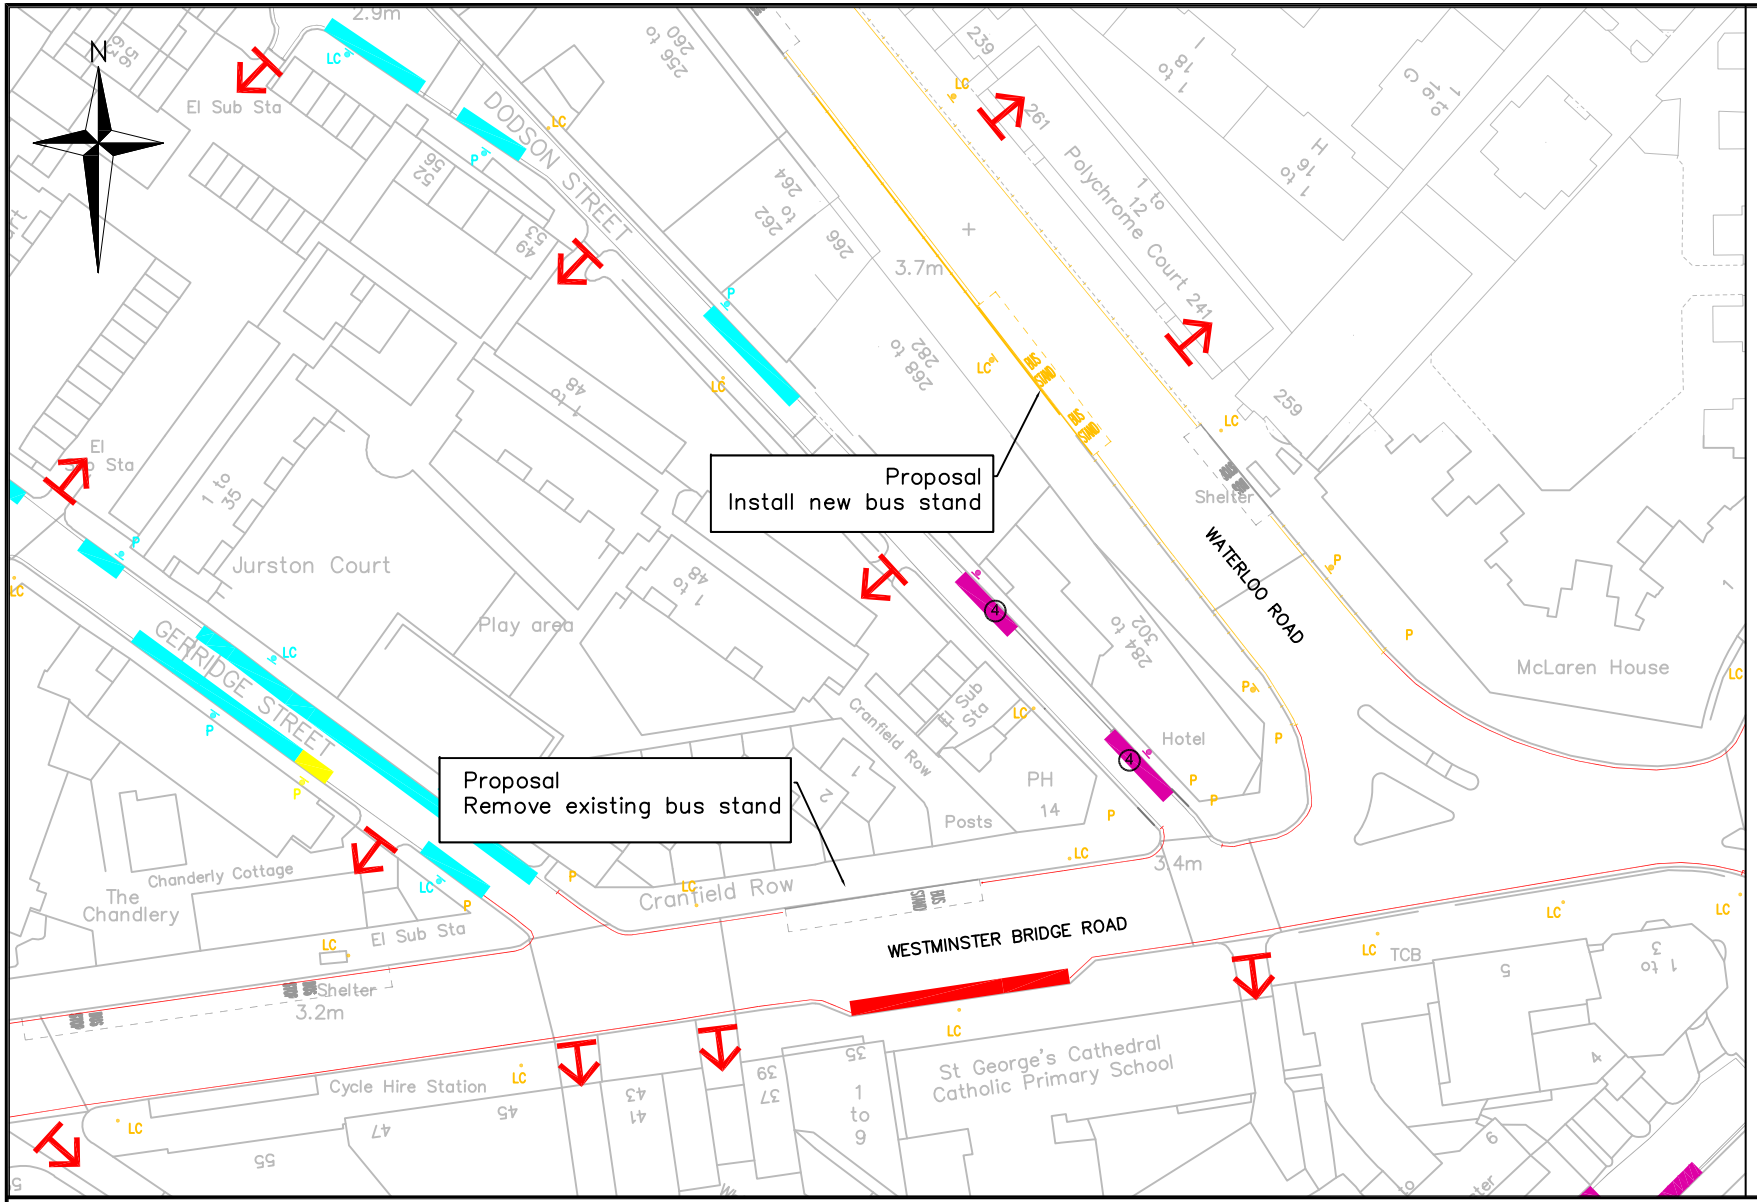

Public Realm Projects
Parking Design

Environment and Leisure
Floor 3, hub 1
Southwark Council
160 Tooley Street
PO Box 64529
London, SE1P 5LX

www.southwark.gov.uk/parkingprojects

Southwark Council

Project
1516 LOCAL PARKING AMENDMENTS

Drawing Title
WATERLOO ROAD
RELOCATE BUS STAND
SUBJECT TO TFL WORKS

Community Council
BOROUGH, BANKSIDE AND WALWORTH

Ward(s)
CATHEDRALS

Date	Scale	Drn	Chk	App
26/08/15	1:1000 @ A4	MH	LC	LC

Dwg No. 1516Q2

Rev A

Status APPENDIX 6

Rev	Date	Description	Drn	Chk	App

© Crown copyright. All rights reserved ((0)100019252) 2013

APPENDIX 6

\\lbsjsh-cha-ns1\151share\NET_DEV\01_PROJECTS\2006_07\C2_CPZ_4TH_2006\11 Design Drawings\04 As Built\C2_AB_V5.dwg.